



GENERAL NOTES
 DRAWING CAN BE SCALED FOR PLANNING PURPOSES ONLY BUT IF IN ANY DOUBT ABOUT A DIMENSION OR ANY OF THE DRAWN INFORMATION PLEASE ASK CDRB ARCHITECTS LTD.

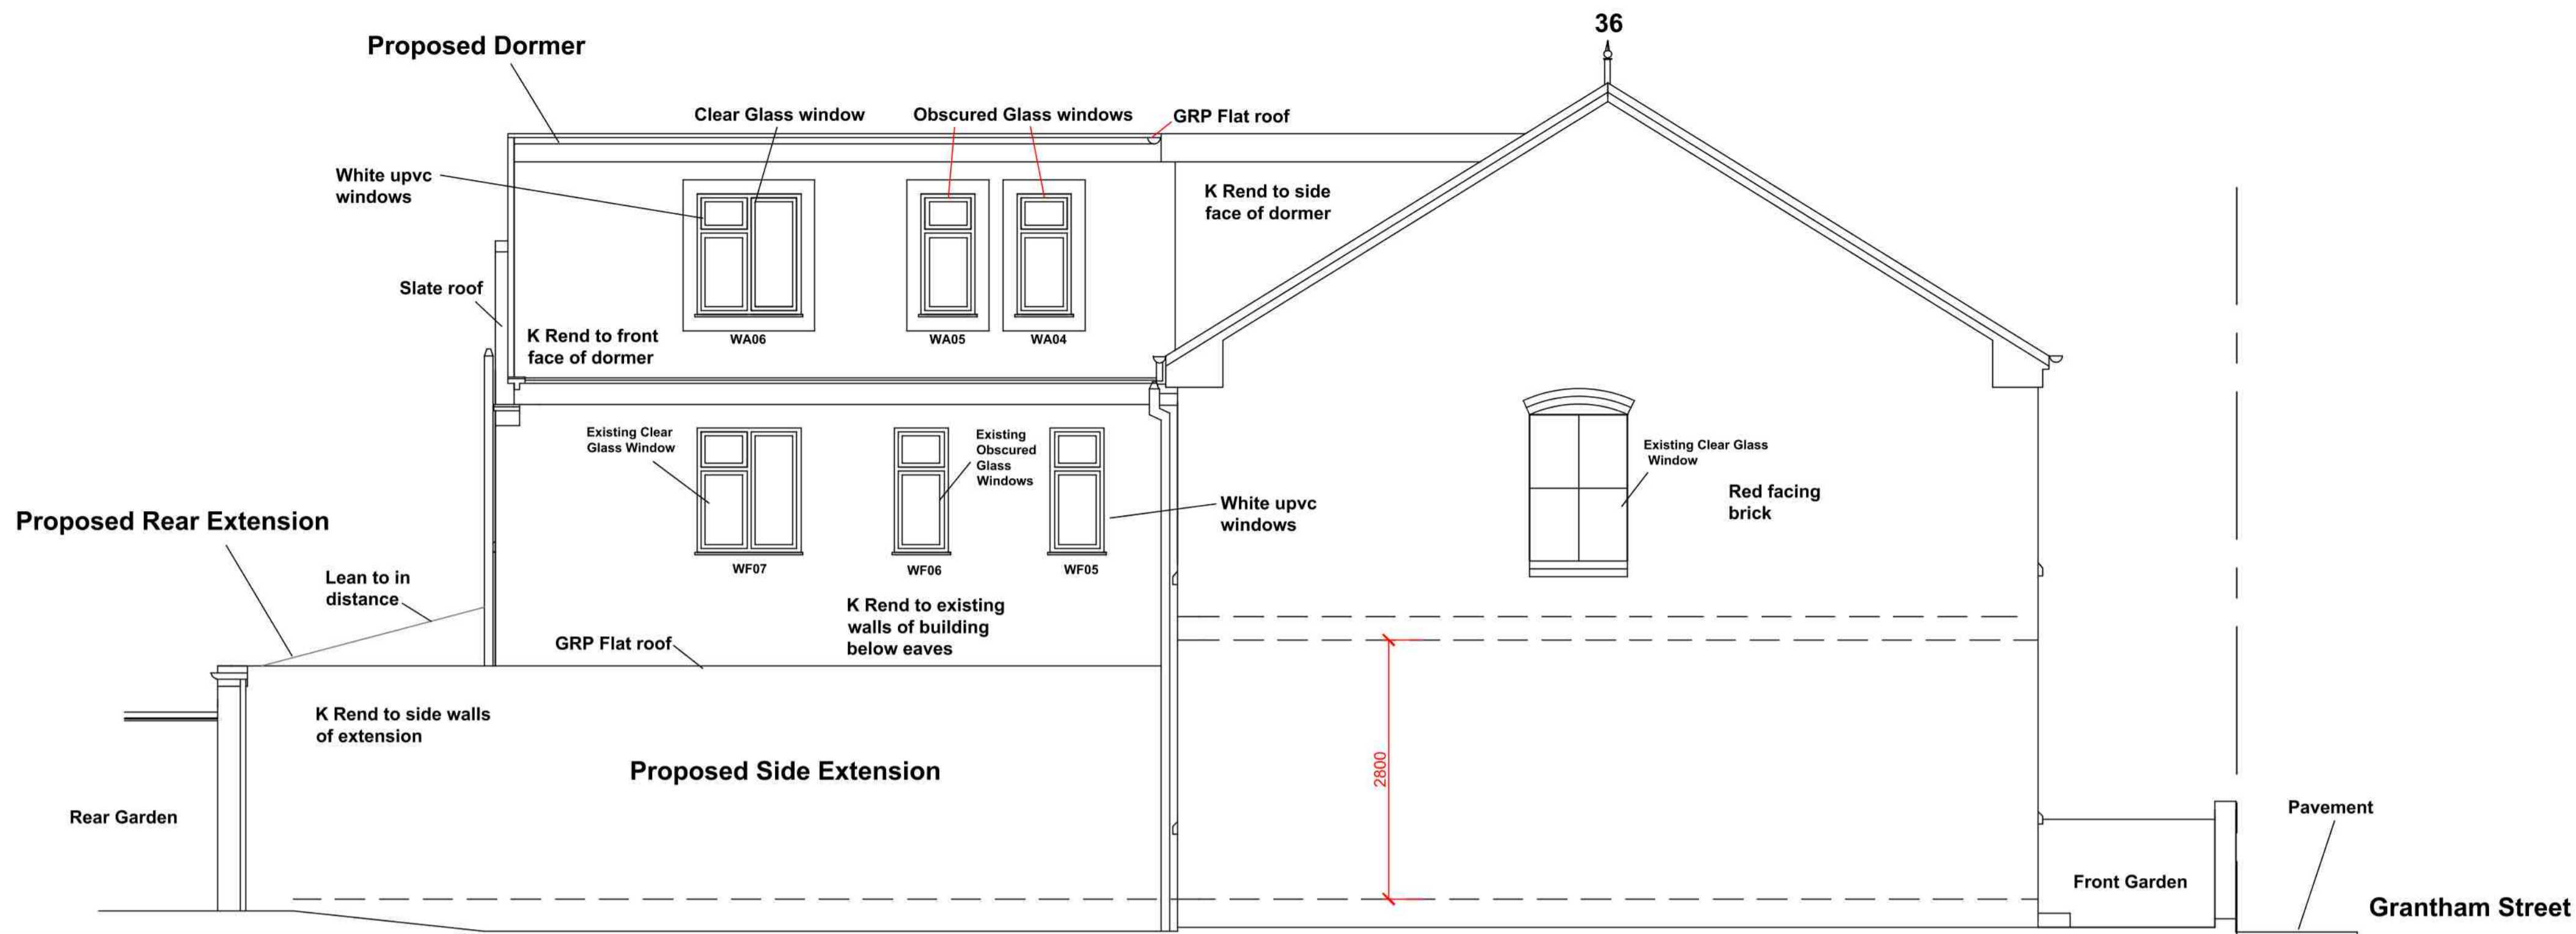


**As Built Side Elevation Facing No 38 Grantham Street-
 Scale 1:50 @ A1**

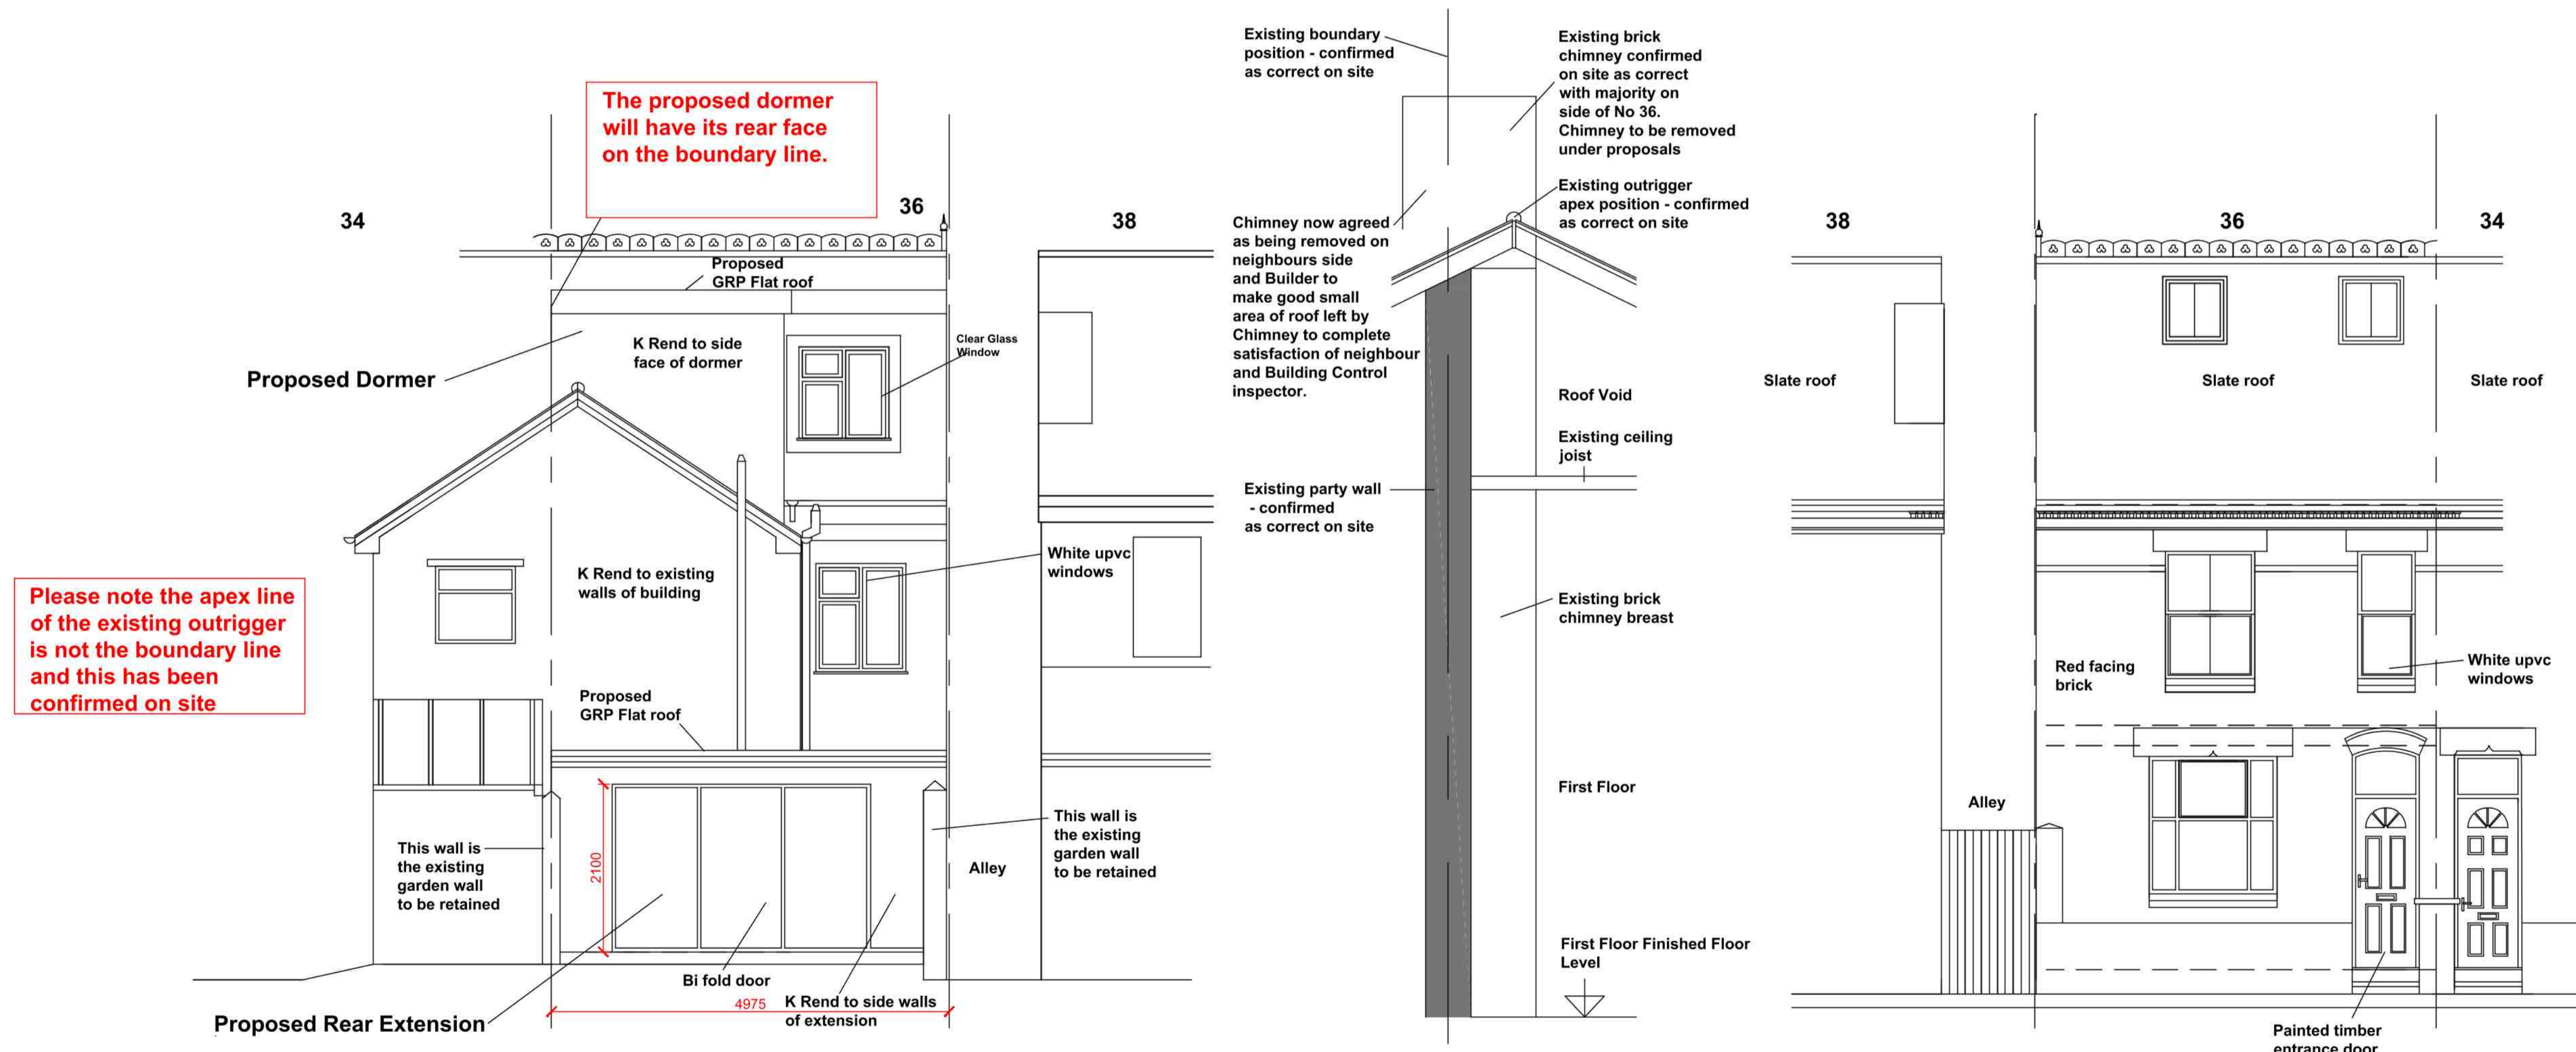

**As Built Rear Elevation Facing Rear Garden -
 Scale 1:50 @ A1**

**Cross Section Through Chimney to Clarify and Explain Existing Boundary Position
 Scale 1:20 @ A1**

**Proposed Front Elevation Facing Grantham Street
 Scale 1:50 @ A1**

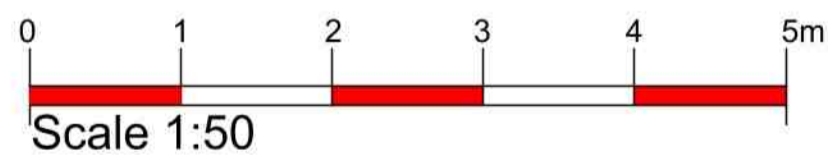

PLANNING SUBMISSION

| | | | | |
|--------------------------------------|-------------|---|------------|-------|
| A | 24.10.19 | Window amendments | jf | cdrb |
| revn | date | | by | chckd |
| | | cdrb architects ltd 9 Milar Court, 43 Station Road, Kenilworth, CV8 1JD | | |
| | | job title Proposed Change of Use from C3 to 3 No Flats at 36 Grantham Street, Coventry | | |
| drawing title Proposed Elevations | | | | |
| scale | drawn by | date | checked by | |
| 1:50 @ A1 | RA | September 2019 | CDRB | |
| job no. | drawing no. | revision | | |
| T1756 | AL (P) 05 | A | | |